

DEPARTMENT OF COUNTY ENGINEER
DIVISION OF BUILDING AND SAFETY
COUNTY OF LOS ANGELES
WILLIAM J. FOX, COUNTY ENGINEER

SEWER—SEWAGE DISPOSAL
PERMIT APPLICATION

1

FOR APPLICANT TO FILL IN

BUILDING ADDRESS **4338 FLORAL DR**

LOCALITY **E.L.A.**

NEAREST CROSS ST. **EASTERN AVE**

OWNER **C. RAMO'S**

MAIL ADDRESS **4338 FLORAL DR**

CITY **L.A.** TEL. NO.

CONTRACTOR **G.C. Cuertis P/ly.**

ADDRESS **3917 LE SAGE**

CITY **LYNWOOD** TEL. NO. **NC 22138**

REGISTRATION NO. **114630** ☐ STATE ☒ COUNTY

LEGAL DESCRIPTION LOT NO. **8**

BLOCK **23** TRACT **Operation HTs**

SIZE OF LOT **50X110** NO. OF BLDGS. NOW ON LOT **3**

USE OF BUILDINGS **Dwellings**

NO.	DESCRIPTION OF WORK	FEE
	HOUSE SEWER CONNECTING TO PUBLIC SEWER @ \$ 3.50	
	HOUSE SEWER CONNECTING TO PRIVATE DISPOSAL SYSTEM 1.00	
1	CONNECT ADDITIONAL BLDG. TO HOUSE SEWER 1.00	1.00
	ALTER OR REPAIR EXISTING SEWER OR DISPOSAL SYSTEM 1.00	
	DISCONNECT AND ABANDON SEWER AND/OR DISPOSAL SYSTEM 1.00	
	SEPTIC TANK, SEEP. PIT OR PITS AND/OR DRAINFIELD 2.00	
	CESSPOOL—DRYWELL SPECIAL CONDITIONS ONLY 2.00	

OWNERS AUTHORIZATION

PERMIT \$ **1 00**

TOTAL FEE **2 00**

I HAVE THIS DATE CONTRACTED WITH THE HEREIN NAMED CONTRACTOR TO CONNECT THE ABOVE DESCRIBED EXISTING DWELLING TO THE PUBLIC SEWER

SIGNED THIS **19** DAY OF **4/19/54** 1954

OWNER OR OWNERS AGENT **C. Ramo's**

ADDRESS **4338 Floral Dr.**

I HEREBY ACKNOWLEDGE THAT I HAVE READ THIS APPLICATION AND STATE THAT THE ABOVE IS CORRECT AND AGREE TO COMPLY WITH ALL COUNTY ORDINANCES AND STATE LAWS REGULATING PLUMBING AND SEWERS.

I HEREBY CERTIFY THAT I AM PROPERLY REGISTERED AND/OR LICENSED AS REQUIRED BY LOS ANGELES COUNTY AND STATE OF CALIFORNIA OR THAT I AM THE LEGAL OWNER OF THE ABOVE DESCRIBED RESIDENTIAL PROPERTY.

SIGNATURE OF PERMITTEE **G.C. Cuertis**

BUILDING ADDRESS **4338 FLORAL DR.**

LOCALITY **E.L.A.**

NEAREST CROSS ST. **HUMPHREY**

DISTRICT NO. **G** Ready for Inspection **CALL** PERMIT NO. **35352-S**

RECEIVED BY **Gallego** DATE **11-19-54** ISSUED BY **Gallego** DATE **11-19-54**

USE ZONE **C-3** OCCUPANCY **1 FAM. RES.** MAP BK PG **N-81**

CO. IMP. NO. **820 1-D**

JOB NO.

TRUNK PERMIT NO.

ROAD PERMIT NO.

STATE ENCROACHMENT PERMIT NO.

INDUSTRIAL WASTE APPROVAL

CHARGES

CONNECTION CHARGE FEE

REIMBURSEMENT FEE

RECEIPT NO. DATE BY

EXCEPTION RECORDED

NO. DATE BY

CONNECTION DATA

STATION DEPTH

MANHOLE REFERENCE UPPER LOWER

TYPE OF CONNECTION Y. CURB P.L. LENGTH FROM M.L. TO P.L.

APPROVALS

INSPECTOR'S SIGNATURE DATE

NEW HOUSE SEWER

CONNECT ADDITIONAL BUILDING OR WORK

SEPTIC TANK, SEEP. PIT(S) AND/OR DRAINFIELD

CESSPOOL ☐ DRYWELL ☐

ALTER, REPAIR, SEWER OR SEWAGE DISPOSAL SYSTEM

DISCONNECT PLUG AND ABANDON HOUSE SEWER


BACKFILL SEPTIC TANKS ☐ SEEP. PIT(S) ☐ CESSPOOLS ☐

FOR DEPARTMENT USE

REQUIRED INFORMATION

1. INDICATE ALL BUILDINGS ON PROPERTY.
2. INDICATE AND DIMENSION SEWAGE DISPOSAL SYSTEM WITH TIE DISTANCES TO BUILDINGS AND PROPERTY LINES.
3. INDICATE SIZE OF SEPTIC TANK—DEPTH OF SEEPAGE PIT(S)—SIZE OF CESSPOOL(S)
4. INDICATE NORTH DIRECTION ON PLOT.
5. INDICATE BOTH STREETS IF CORNER.

4" VCP.
CEWJTS.

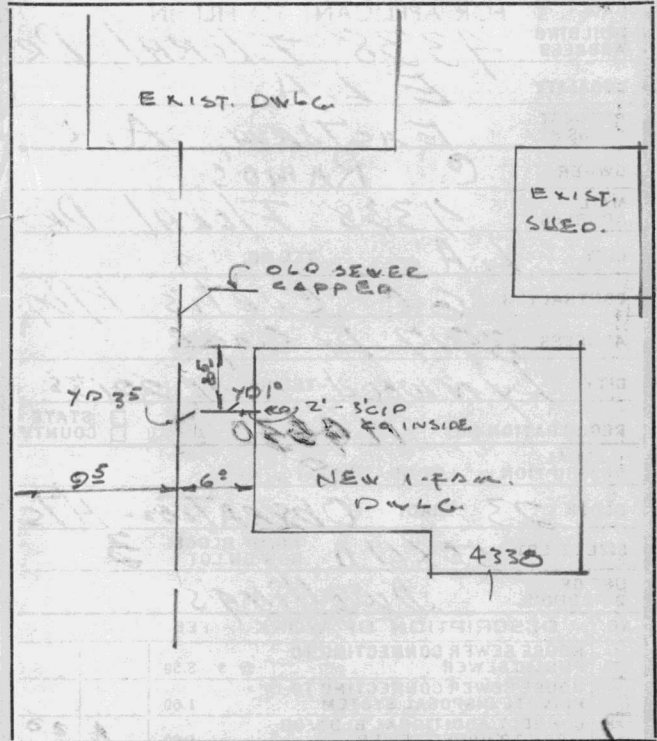

LEGAL DESCRIPTION

E. FLORAL DR. ST. ALLEY R/W

FIELD NOTES